#241

AF 35967B

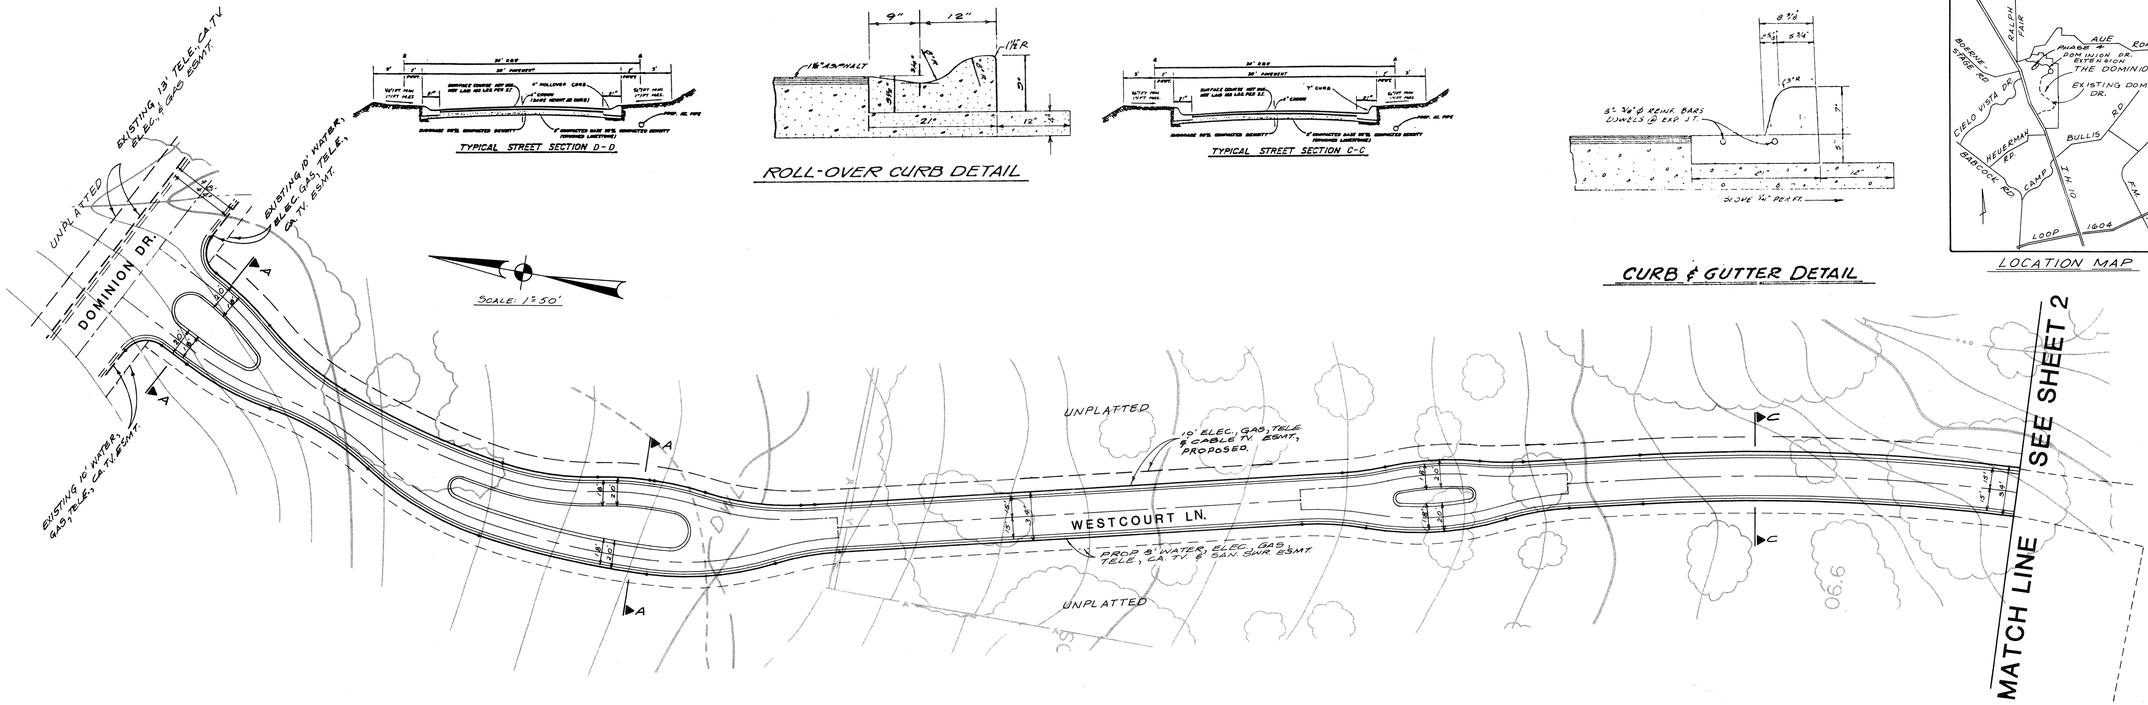








ROLL-OVER CURB DETAIL







CURB & GUTTER DETAIL

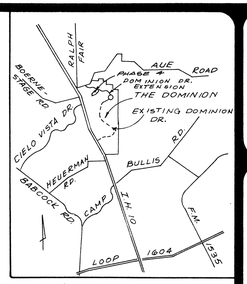


LOCATION MAP

**REVISIONS:** 10-11-91 ADDED 20' ESMT. ALONG BASE 8-26-85 ESMT. DESCRIP. REVISED
11-17-85 ADDED NOTES #1 & #2
6-4-92 ADDED NOTE TO INCLUDE THE DOMINION, PHASE 2 (58.4 AC.) LOTS 1-7 BLK 3 & LOTS 1-5 BLK 4

RECEIVED
OCT 7 PM 3:10
CITY PLANNING DEPARTMENT


PAPE-DAWSON ENGINEERS
CIVIL & ENVIRONMENTAL
9310 BROADWAY SAN ANTONIO, TEXAS 78217 512-824-9484


# THE DOMINION PHASE 4

PLANNED UNIT DEVELOPMENT

## FINAL PLAN

JOB NO. 2194-04
DATE JUNE 85
DESIGNER JR
CHECKED JD DRAWN RWB
SHEET 1 OF 3

## TOTAL AREA OF PROPOSED PROJECT

Total area of project =
Proposed-141 single family residential lots
Approximately 2,500 sq. ft. of floor area each
Lot sizes vary - Minimum width: 50' = 3.6 lots per acre.
Minimum size: 5,387 sq. ft.

Proposed project: 145 x 2,500 = 362,500 sq. ft. of proposed floor area.
1,249,993 sq. ft. of proposed open space.
885,800 sq. ft. of proposed livability space.

Required by P.U.D. Ordinance:
Allowable floor area (F.A.) = 435,014 sq. ft. gross area X ratio
Required open space (O.S.) = 962,500 sq. ft. proposed area X ratio
Required livability space (L.S.) = 616,250 sq. ft. proposed floor area X ratio

## RESIDENTIAL LOT SIZES

| BLOCK | LOT | AREA (SQ. FT.) | BLOCK | LOT | AREA (SQ. FT.) | BLOCK | LOT | AREA (SQ. FT.) | BLOCK | LOT | AREA (SQ. FT.) | BLOCK | LOT | AREA (SQ. FT.) | BLOCK | LOT | AREA (SQ. FT.) | BLOCK | LOT | AREA (SQ. FT.) |
|---|---|---|---|---|---|---|---|---|---|---|---|---|---|---|---|---|---|---|---|---|
| 15 | 1 | 7,808 | 15 | 24 | 6,731 | 15 | 45 | 7,793 | 15 | 66 | 6,270 | 15 | 87 | 7,882 | 15 | 108 | 8,286 | 15 | 129 | 6,806 |
| 15 | 2 | 7,986 | 15 | 25 | 6,391 | 15 | 46 | 6,325 | 15 | 67 | 5,867 | 15 | 88 | 7,001 | 15 | 109 | 8,355 | 15 | 130 | 6,703 |
| 15 | 3 | 6,546 | 15 | 26 | 6,653 | 15 | 47 | 6,325 | 15 | 68 | 5,850 | 15 | 89 | 6,310 | 15 | 110 | 7,816 | 15 | 131 | 6,792 |
| 15 | 4 | 6,074 | 15 | 27 | 6,391 | 15 | 48 | 7,638 | 15 | 69 | 6,114 | 15 | 90 | 6,310 | 15 | 111 | 6,796 | 15 | 132 | 6,280 |
| 15 | 5 | 6,104 | 15 | 28 | 6,710 | 15 | 49 | 9,056 | 15 | 70 | 6,287 | 15 | 91 | 6,310 | 15 | 112 | 6,252 | 15 | 133 | 7,840 |
| 15 | 6 | 6,343 | 15 | 29 | 7,391 | 15 | 50 | 7,340 | 15 | 71 | 6,044 | 15 | 92 | 6,383 | 15 | 113 | 7,383 | 15 | 134 | 7,942 |
| 15 | 7 | 6,871 | 15 | 30 | 8,604 | 15 | 51 | 6,465 | 15 | 72 | 5,387 | 15 | 93 | 9,508 | 15 | 114 | 6,241 | 15 | 135 | 8,226 |
| 15 | 8 | 6,709 | 15 | 31 | 7,516 | 15 | 52 | 6,392 | 15 | 73 | 8,966 | 15 | 94 | 7,512 | 15 | 115 | 6,382 | 15 | 136 | 6,587 |
| 15 | 9 | 6,708 | 15 | 32 | 7,291 | 15 | 53 | 6,419 | 15 | 74 | 7,888 | 15 | 95 | 7,589 | 15 | 116 | 5,900 | 15 | 137 | 6,587 |
| 15 | 10 | 6,708 | 15 | 33 | 6,395 | 15 | 54 | 6,584 | 15 | 75 | 6,114 | 15 | 96 | 8,008 | 15 | 117 | 6,418 | 15 | 138 | 8,226 |
| 15 | 11 | 7,997 | 15 | 34 | 6,418 | 15 | 55 | 7,126 | 15 | 76 | 5,700 | 15 | 97 | 7,844 | 15 | 118 | 6,500 | 15 | 139 | 6,227 |
| 15 | 12 | 6,566 | 15 | 35 | 7,538 | 15 | 56 | 6,056 | 15 | 77 | 6,326 | 15 | 98 | 8,524 | 15 | 119 | 7,019 | 15 | 140 | 6,050 |
| 15 | 13 | 6,723 | 15 | 36 | 6,414 | 15 | 57 | 5,781 | 15 | 78 | 6,071 | 15 | 99 | 6,157 | 15 | 120 | 7,512 | 15 | 141 | 5,928 |
| 15 | 14 | 7,996 | 15 | 37 | 6,560 | 15 | 58 | 7,059 | 15 | 79 | 5,750 | 15 | 100 | 6,308 | 15 | 121 | 6,132 | 15 | 142 | 7,447 |
| 15 | 15 | 7,323 | 15 | 38 | 7,159 | 15 | 59 | 6,445 | 15 | 80 | 5,757 | 15 | 101 | 6,431 | 15 | 122 | 6,699 | 15 | 143 | 5,412 |
| 15 | 16 | 8,321 | 15 | 39 | 6,881 | 15 | 60 | 6,770 | 15 | 81 | 6,188 | 15 | 102 | 9,804 | 15 | 123 | 7,059 | ~~15~~ | ~~144~~ | ~~5,904~~ A (****) |
| ~~15~~ | ~~17~~ | ~~11,714~~ * ** | 15 | 40 | 6,081 | 15 | 61 | 6,770 | 15 | 82 | 6,568 | ~~15~~ | ~~103~~ | ~~10,200~~ *** | 15 | 124 | 9,548 | 15 | 151 | 10,987 * |
| ~~15~~ | ~~19~~ | ~~10,905~~ * ** | 15 | 41 | 6,782 | 15 | 62 | 7,580 | 15 | 83 | 6,435 | ~~15~~ | ~~104~~ | ~~5,236~~ * ** | 15 | 125 | 7,387 | 15 | 152 | 5,604 * |
| ~~15~~ | ~~20~~ | ~~10,870~~ ** | 15 | 42 | 6,157 | 15 | 63 | 7,792 | 15 | 84 | 8,013 | ~~15~~ | ~~105~~ | ~~5,930~~ * ** | 15 | 126 | 7,582 | 15 | 153 | 7,709 * |
| ~~15~~ | ~~22~~ | ~~11,804~~ | ~~15~~ | ~~43~~ | ~~6,940~~ **** | 15 | 64 | 6,281 | 15 | 85 | 6,008 | 15 | 106 | 7,200 | 15 | 127 | 6,944 | 15 | 154 | 6,947 * |
| 15 | 23 | 7,492 | 15 | 44 | 9,632 | 15 | 65 | 5,668 | 15 | 86 | 7,259 | 15 | 107 | 8,126 | 15 | 128 | 7,420 | 19 | 18 | 7,346 ** |
| | | | | | | | | | | | | | | | | | | 15 | 156 | 7,596 ** |
| | | | | | | | | | | | | | | | | | | 15 | 154 | 7,959 ** |
| | | | | | | | | | | | | | | | | | | 15 | 157 | 7,266 ** |
| | | | | | | | | | | | | | | | | | | 19 | 156 | 8,317 *** |
| | | | | | | | | | | | | | | | | | | 15 | 155 | 9,065 *** |
| | | | | | | | | | | | | | | | | | | 15 | 150 | 6,548 |

TOTAL: 1,039,959 SQ. FT.

* LOT 145, BLOCK 15 WAS PLATTED INTO LOTS 145, 150, 151, 152, 153 AND 154, BLOCK 15 WITH THE DOMINION, PHASE 4B RECORDED IN VOL. 9519, PAGE 55.

** LOTS 17, 18 AND A PORTION OF LOT 20, BLOCK 15 WERE REPLATTED INTO LOTS 18, 155, 156 & 157, BLOCK 15 WITH THE DOMINION, PHASE 4C RECORDED IN VOL. 9615, PG. 168.

*** LOTS 103, 104 AND 105, BLOCK 15 WERE REPLATTED WITH LOTS 138 AND 139 WITH A REPLAT THE DOMINION RECORDED IN VOL. 9524, PG. 85.

**** LOTS 43 AND 190, BLOCK 15 ARE BEING REPLATTED INTO LOT 160, BLOCK 15 WITH THE DOMINION, PHASE 4A.

## GREENBELT LOT SIZES

| BLOCK | LOT | AREA (SQ. FT.) |
|---|---|---|
| 15 | 144 | 5,904 |
| ~~15~~ | ~~145~~ | ~~89,559~~ * |
| 15 | 146 | 145,283 |
| 15 | 147 | 47,911 |
| 16 | 100 | 5,564 * |
| TOTAL | 4 | 204,662 |

## PRIVATE STREET LOT SIZE

| BLOCK | LOT | AREA (SQ. FT.) |
|---|---|---|
| 15 | 148 (Roads, alleys & Loop extension) | 472,726 |
| TOTAL | 1 | 472,726 |

NOTES:
1. STREET INTERSECTIONS SIGHTLINE REQUIREMENTS WILL BE IN ACCORDANCE WITH THE CITY OF SAN ANTONIO, TEXAS, ZONING ORDINANCE SEC. 42-108 3(b) YARDS ABUTTING STREETS.
2. BUILDING SPACING REQUIREMENTS WILL BE IN ACCORDANCE WITH THE CITY OF SAN ANTONIO, TEXAS, ZONING ORDINANCE SEC. 42-108(54) BUILDING SPACING.

THIS PLAN UPDATES THE PREVIOUSLY APPROVED PLANNED UNIT DEVELOPMENT PLAN APPROVED BY THE PLANNING COMMISSION.

Dain W. Pass — 10/13/92
DIRECTOR OF PLANNING — DATE

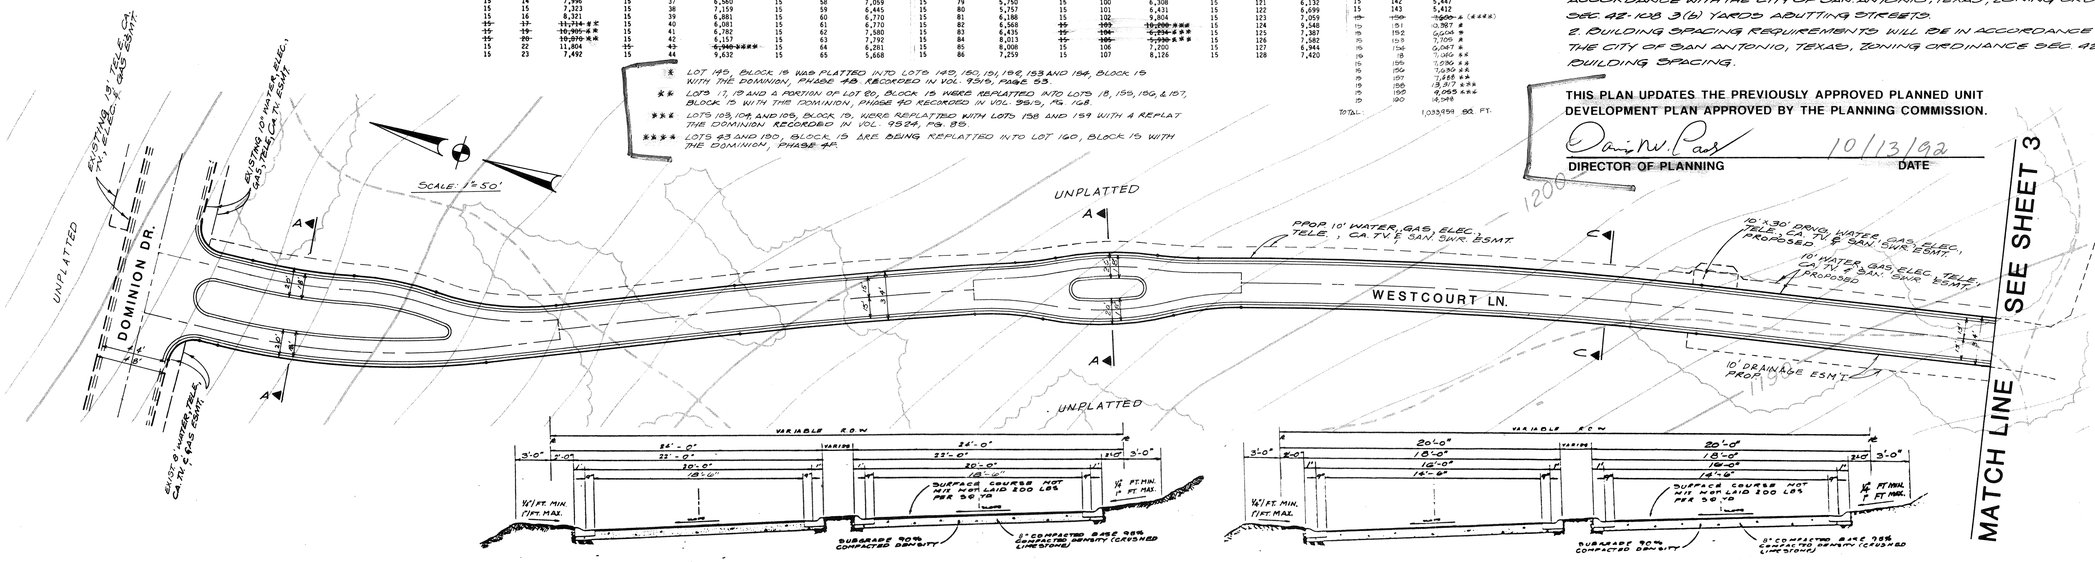





TYPICAL STREET SECTION B-B




TYPICAL STREET SECTION A-A

#241

AF 35967B




# 241

REVISIONS: 6-7-85 ADDED DRAINAGE ESM'TS & REVISED LOTS 9-30-85 ADDED 8" RECLAIM
10-2-85 ADD PLAT TO INCLUDE LOTS 138 & 150

PAPE-DAWSON ENGINEERS
CIVIL & ENVIRONMENTAL
SAN ANTONIO, TEXAS 78217
9310 BROADWAY
512-824-8494

# THE DOMINION PHASE 4

PLANNED UNIT DEVELOPMENT

## FINAL PLAN

JOB NO. 2194-04
DATE JUNE 85
DESIGNER LR
CHECKED JR DRAWN CNB
SHEET 2 OF 3

AF 35967B

LEGEND:

- DOMINION, PHASE 4B
- DOMINION, PHASE 4D
- DOMINION PHASE 4F

LEGEND
4" ROLL-OVER CURB

SCALE: 1"=50'

TYPICAL STREET SECTION A-A

LOCATION MAP

THE DOMINION, PHASE 4B LOTS 152, 153 & 154

PROP. VARIABLE WIDTH DRAINAGE ESMT.

PROP. 16' SAN. SEWER & DRAINAGE ESMT.

PROP. 16' SAN. SWR ESMT.

PROP. 20' DRAINAGE EASEMENT

PROP. 16' SAN SWR ESMT.

PROP. 15' DRNG ESMT.

EXISTING 16' SAN SWR ESMT.

THE DOMINION PHASE 4D LOTS 18, 155 & 156 PREVIOUSLY PLATTED AS LOT 17, 18 & PORTION OF LOT 60

UNPLATTED

GREENBELT LOT 146, BLOCK 15

MAXWELL GLEN

DOULTON LN.

WESTCOURT LN.

HENDON LN.

RUGBY LN.

BURNHAM GLEN

BLOCK 15

20' BUILDING SETBACK LINE

42' R 40' R

MATCH LINE

SEE SHEET 2

SEE LINE

THE DOMINION PHASE 4D LOT 160 PREVIOUSLY PLATTED AS LOTS 150 & 151

THE DOMINION PHASE 4D LOTS 149 & 150 PREVIOUSLY PLATTED AS LOT 145 (GREENBELT)

149 GREENBELT BLK 15

160

UNPLATTED

10' WATER ESMT.

8" WATER ESMT.

8" SEWER ESMT.

10' DRAIN. ESMT.

10' BLDG. SETBACK LINE

TYPICAL STREET SECTION B-B

TYPICAL ALLEY SECTION E-E

TYPICAL STREET SECTION D-D

ROLL-OVER CURB DETAIL

TYPICAL STREET SECTION C-C

CURB & GUTTER DETAIL

REVISIONS:
ADDED THE NEW PHASE PLANNED FOR THE DOMINION PHASE 4B, 4D & 4F

PAPE-DAWSON ENGINEERS
CIVIL & ENVIRONMENTAL
9310 BROADWAY SAN ANTONIO, TEXAS 78217 512-824-9494

# THE DOMINION PHASE 4
PLANNED UNIT DEVELOPMENT
FINAL PLAN

JOB NO. 2194-14
DATE APRIL 1986
DESIGNER JR
CHECKED R DRAWN JWB
SHEET 3 OF 3

#241